






PAGE NO: 1 OF

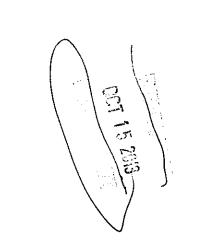


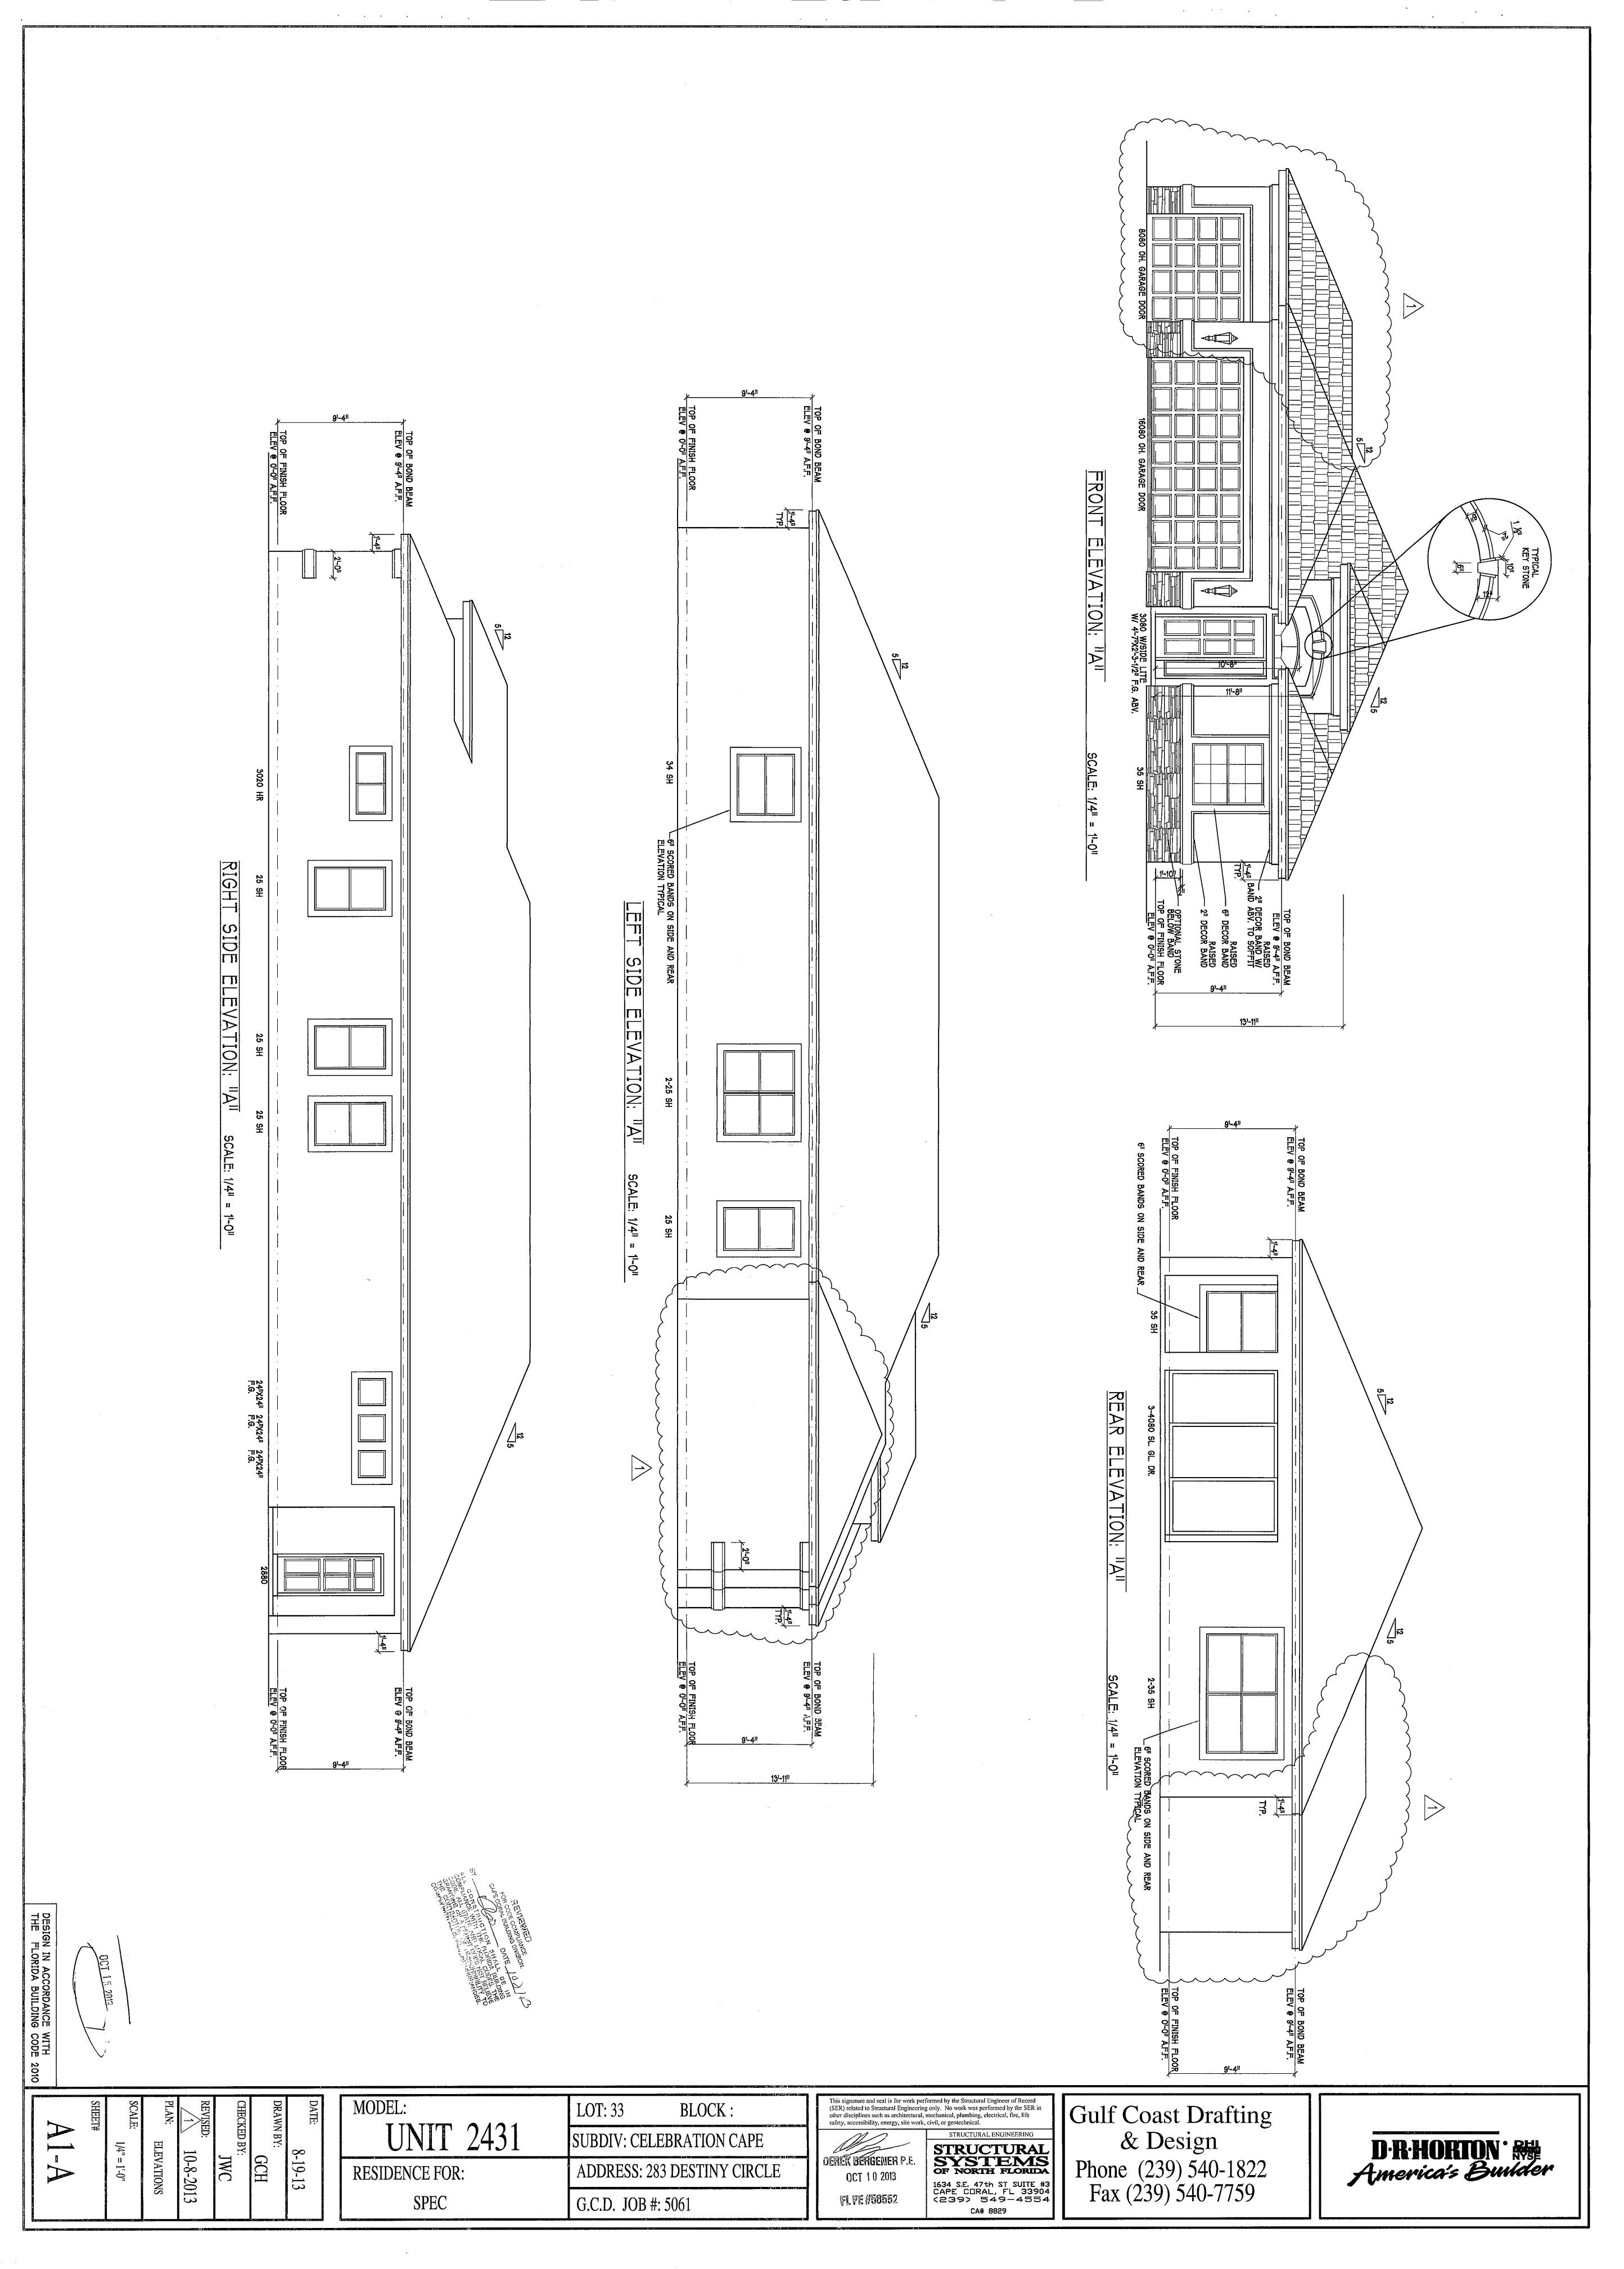


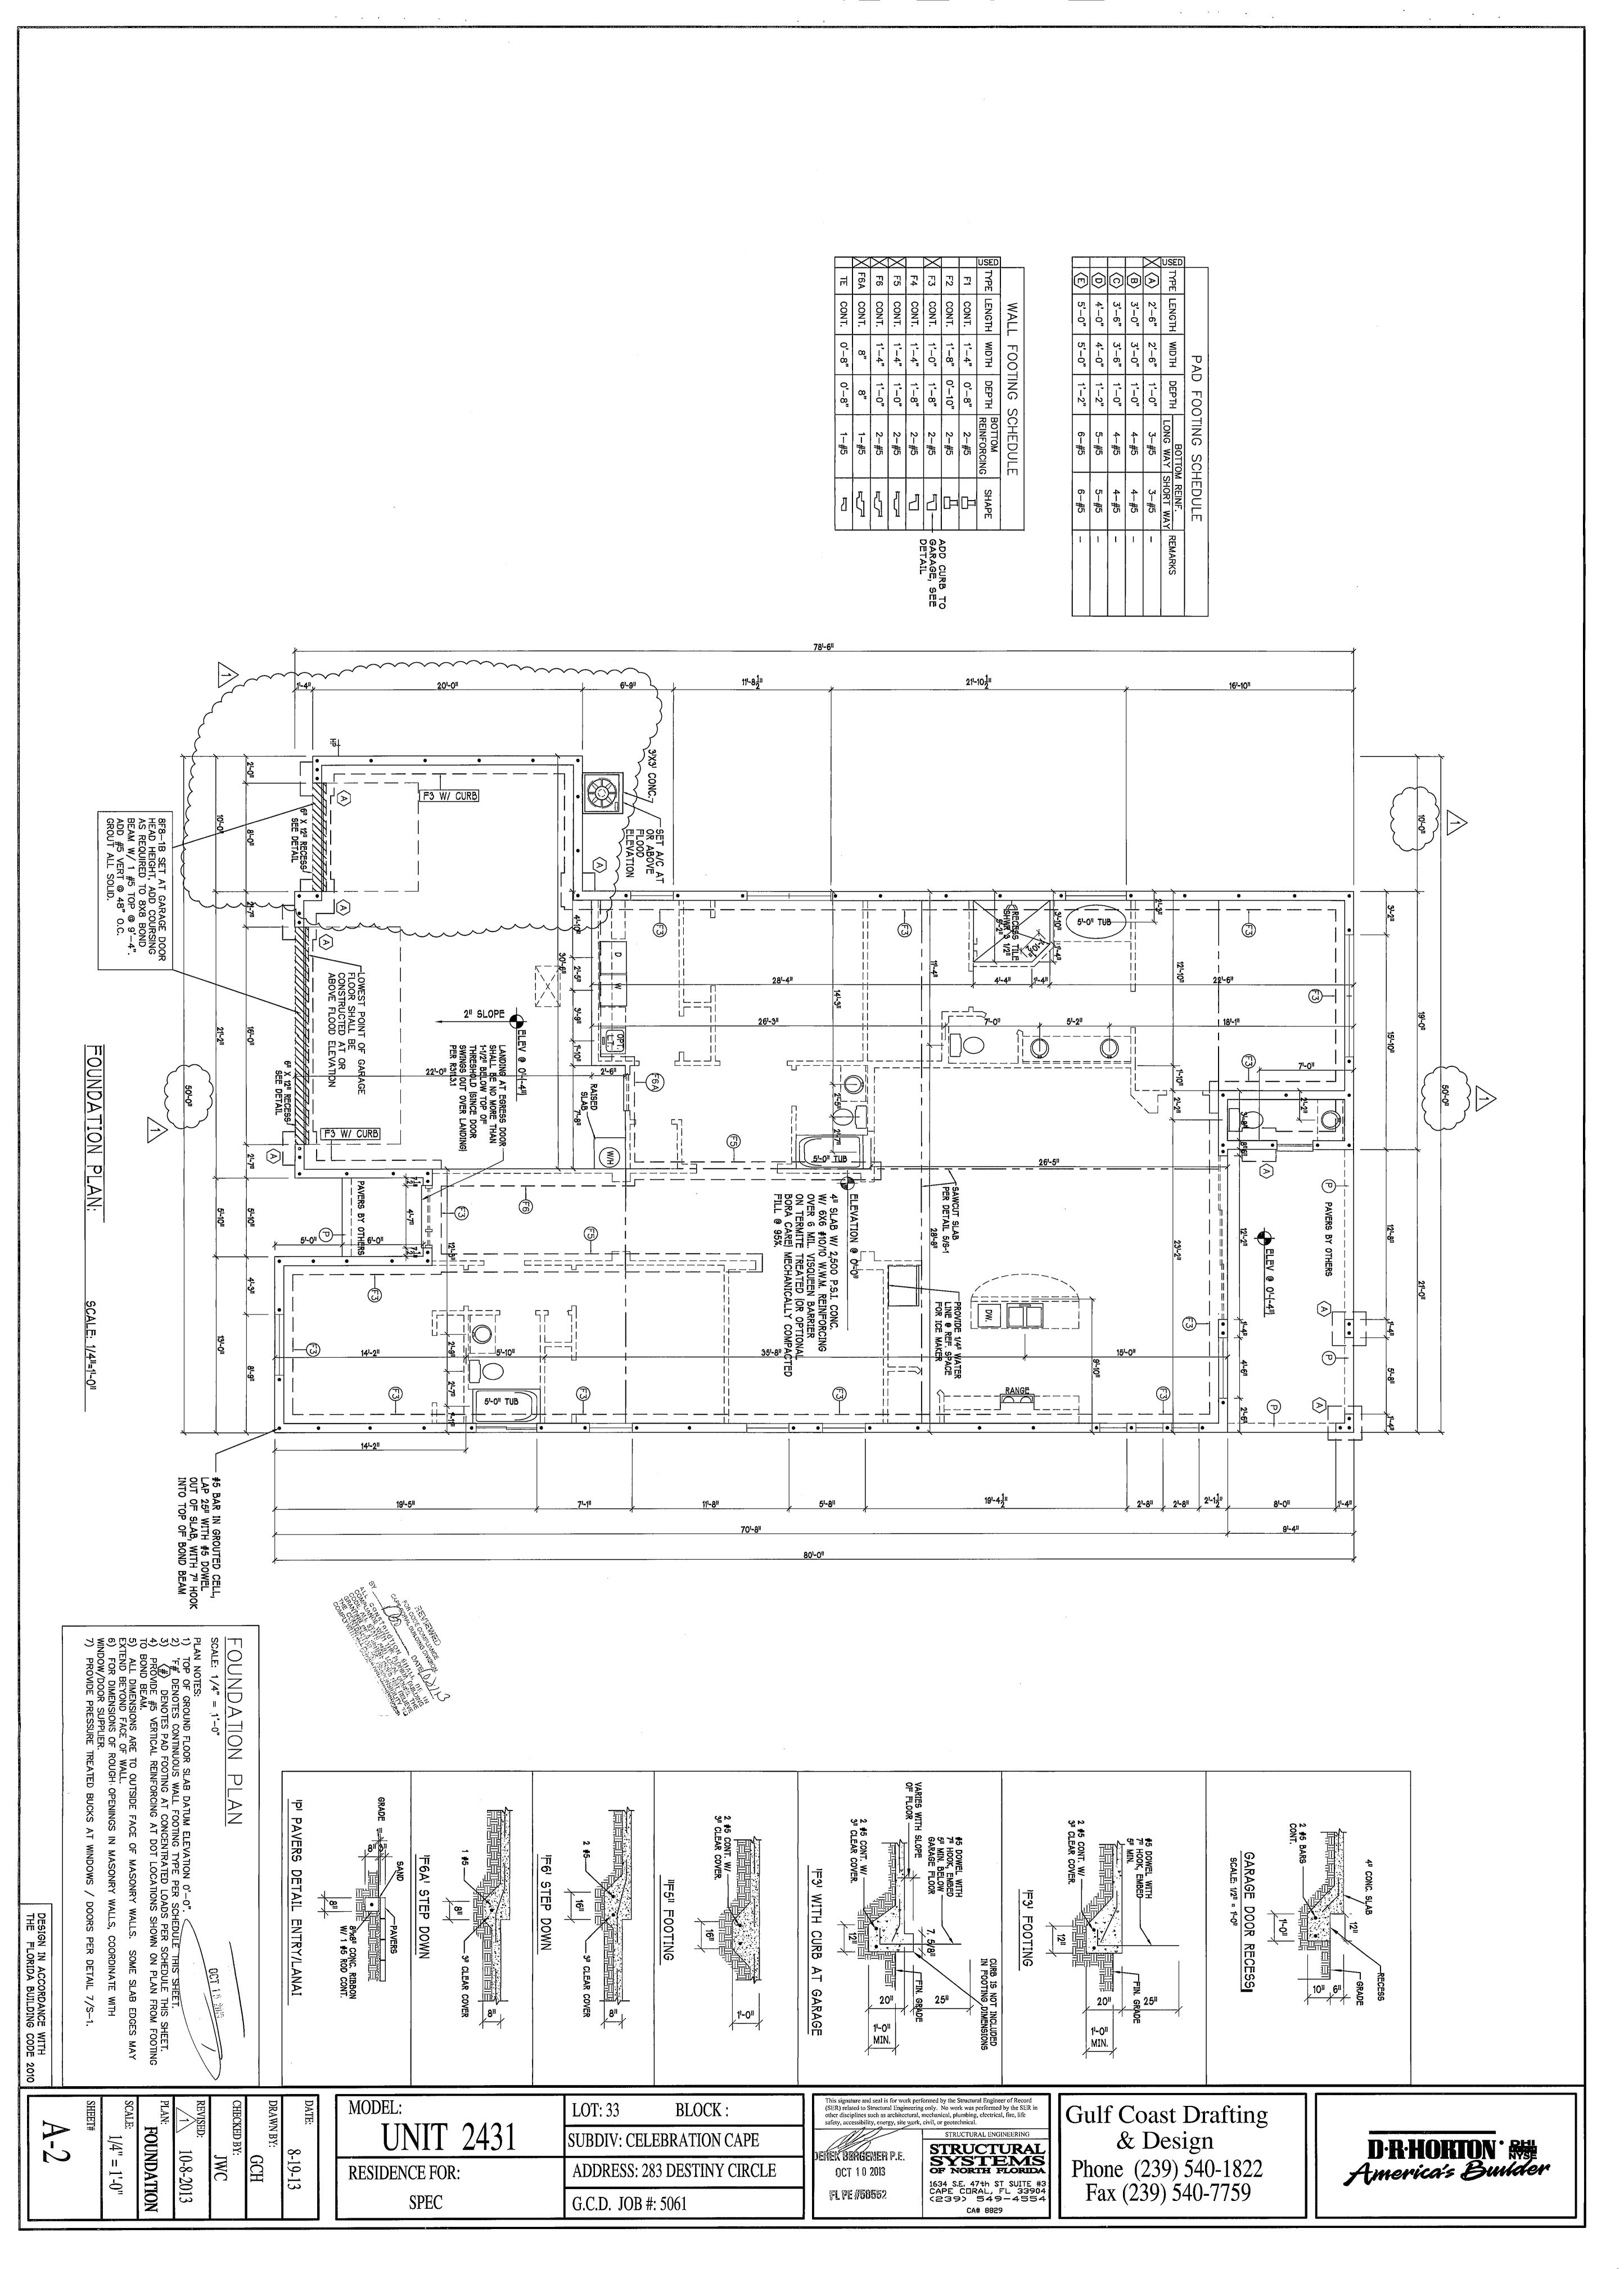


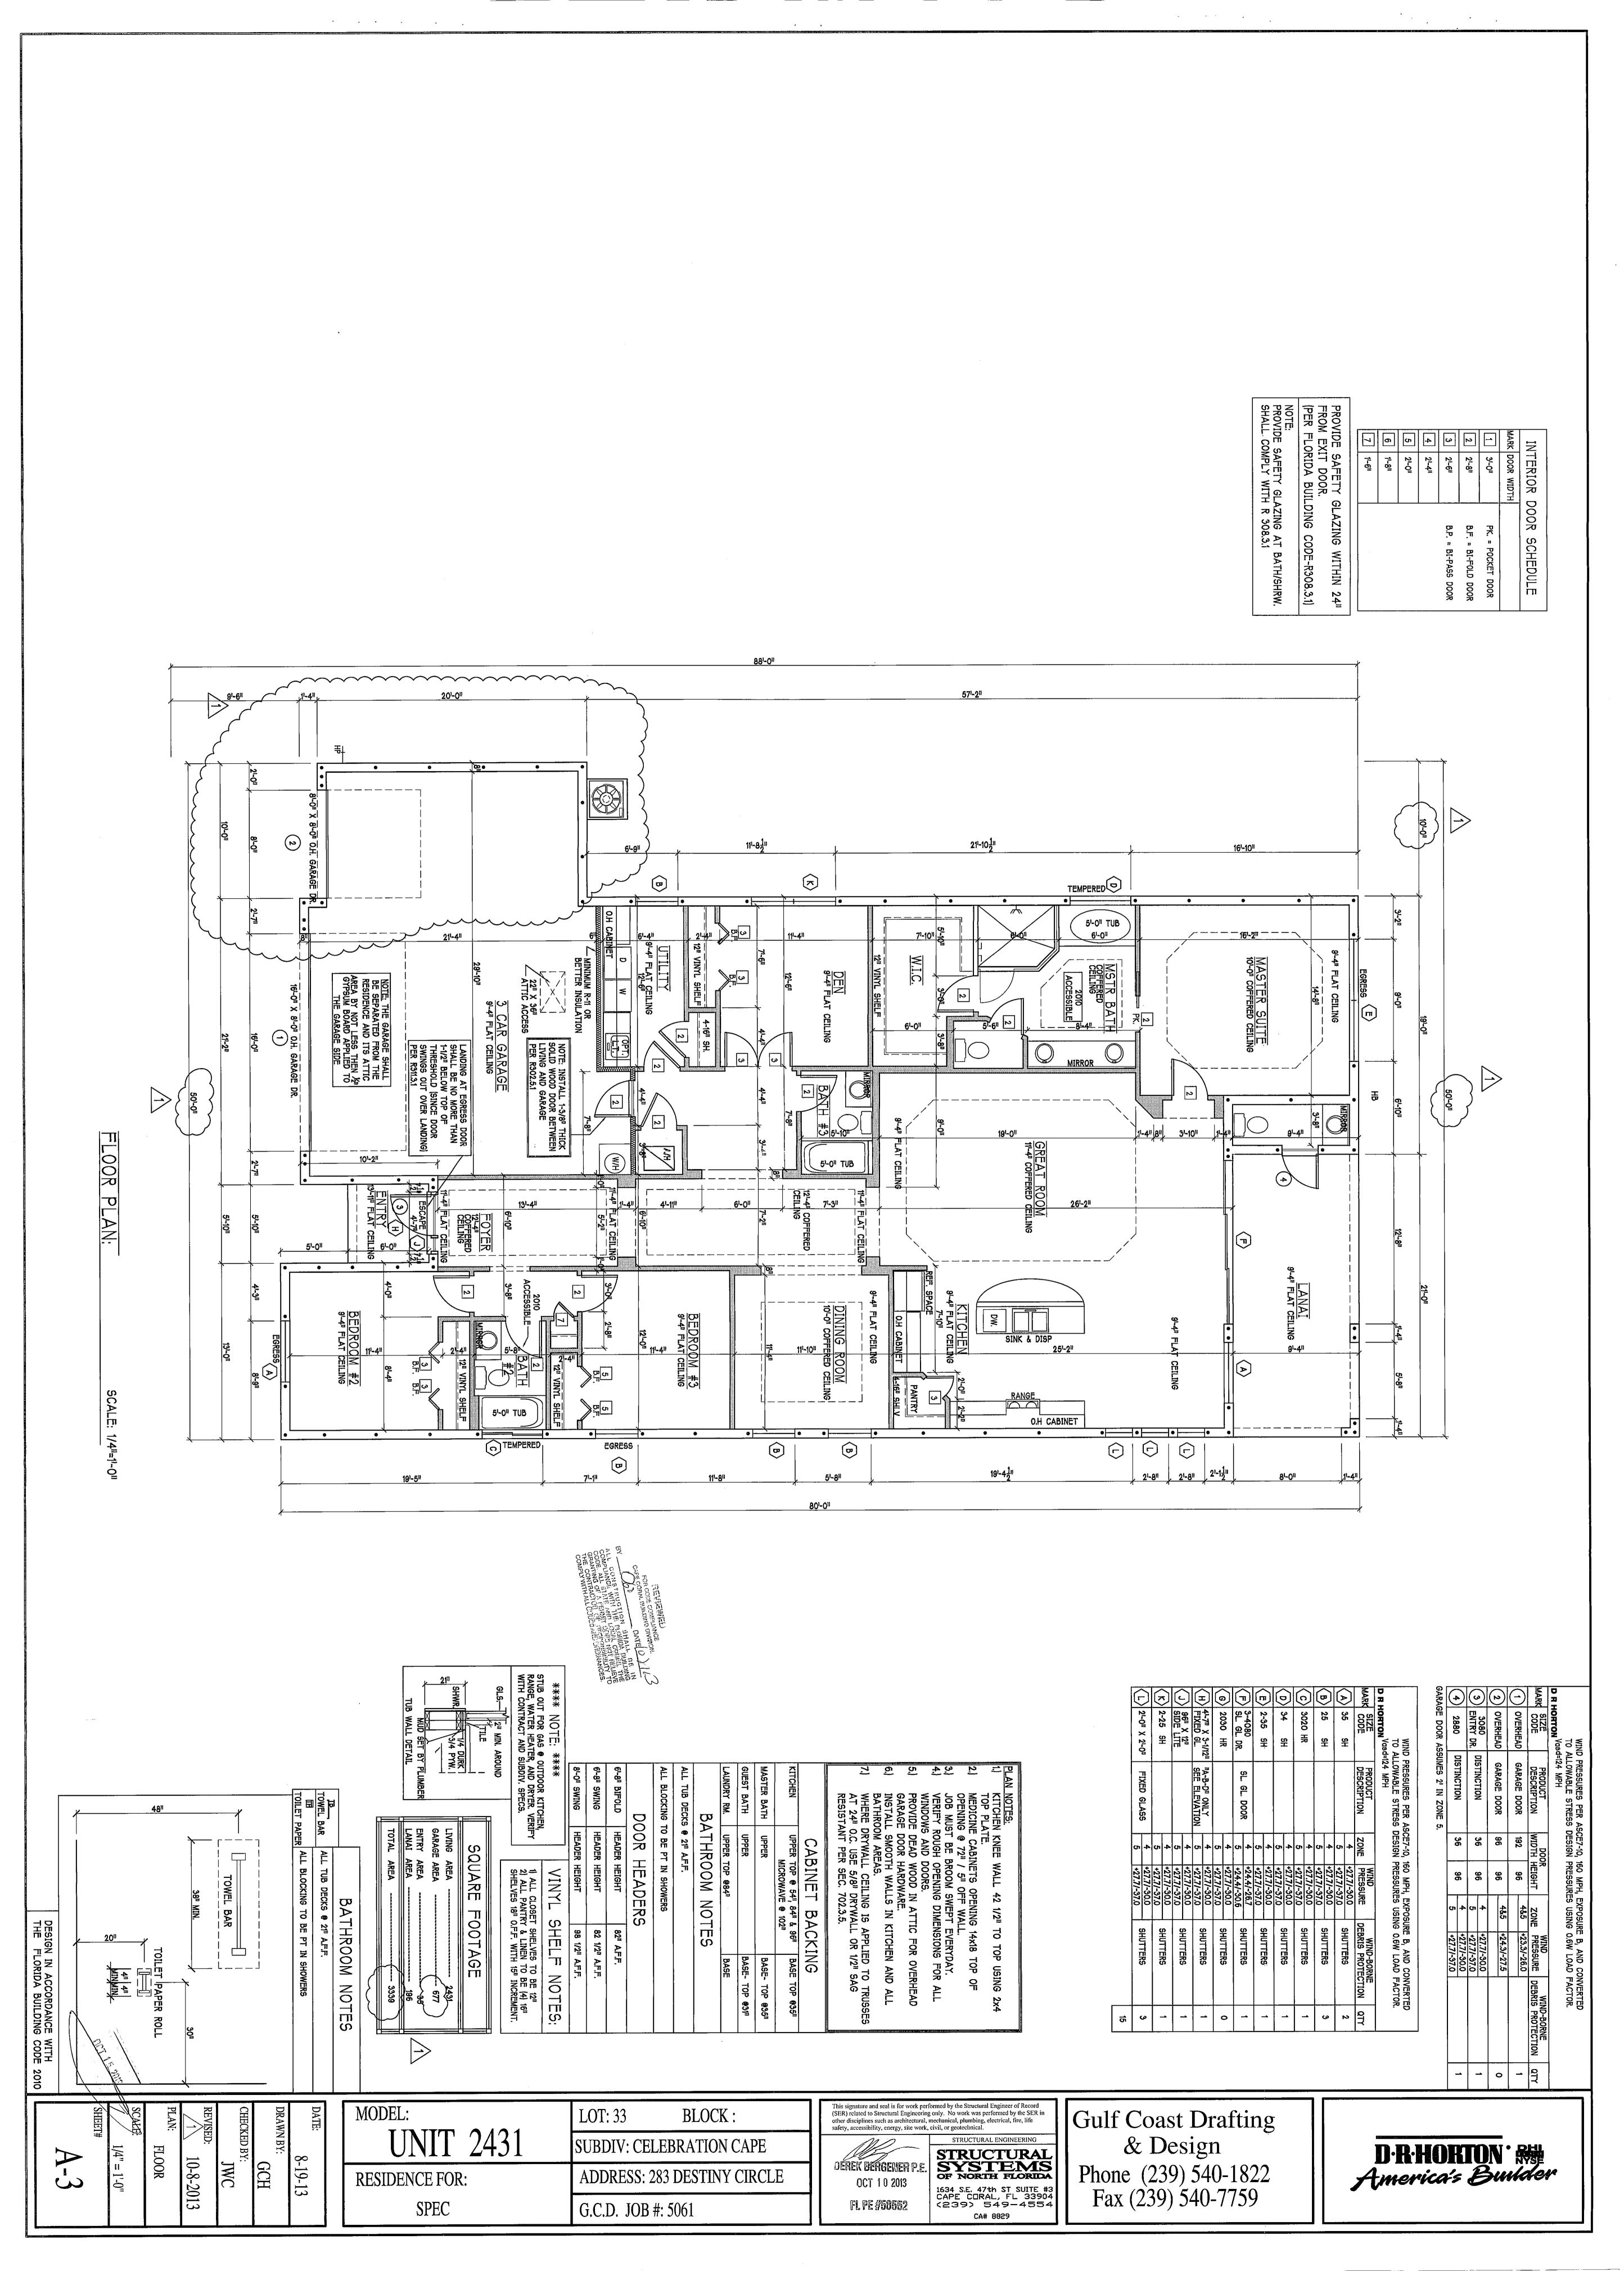

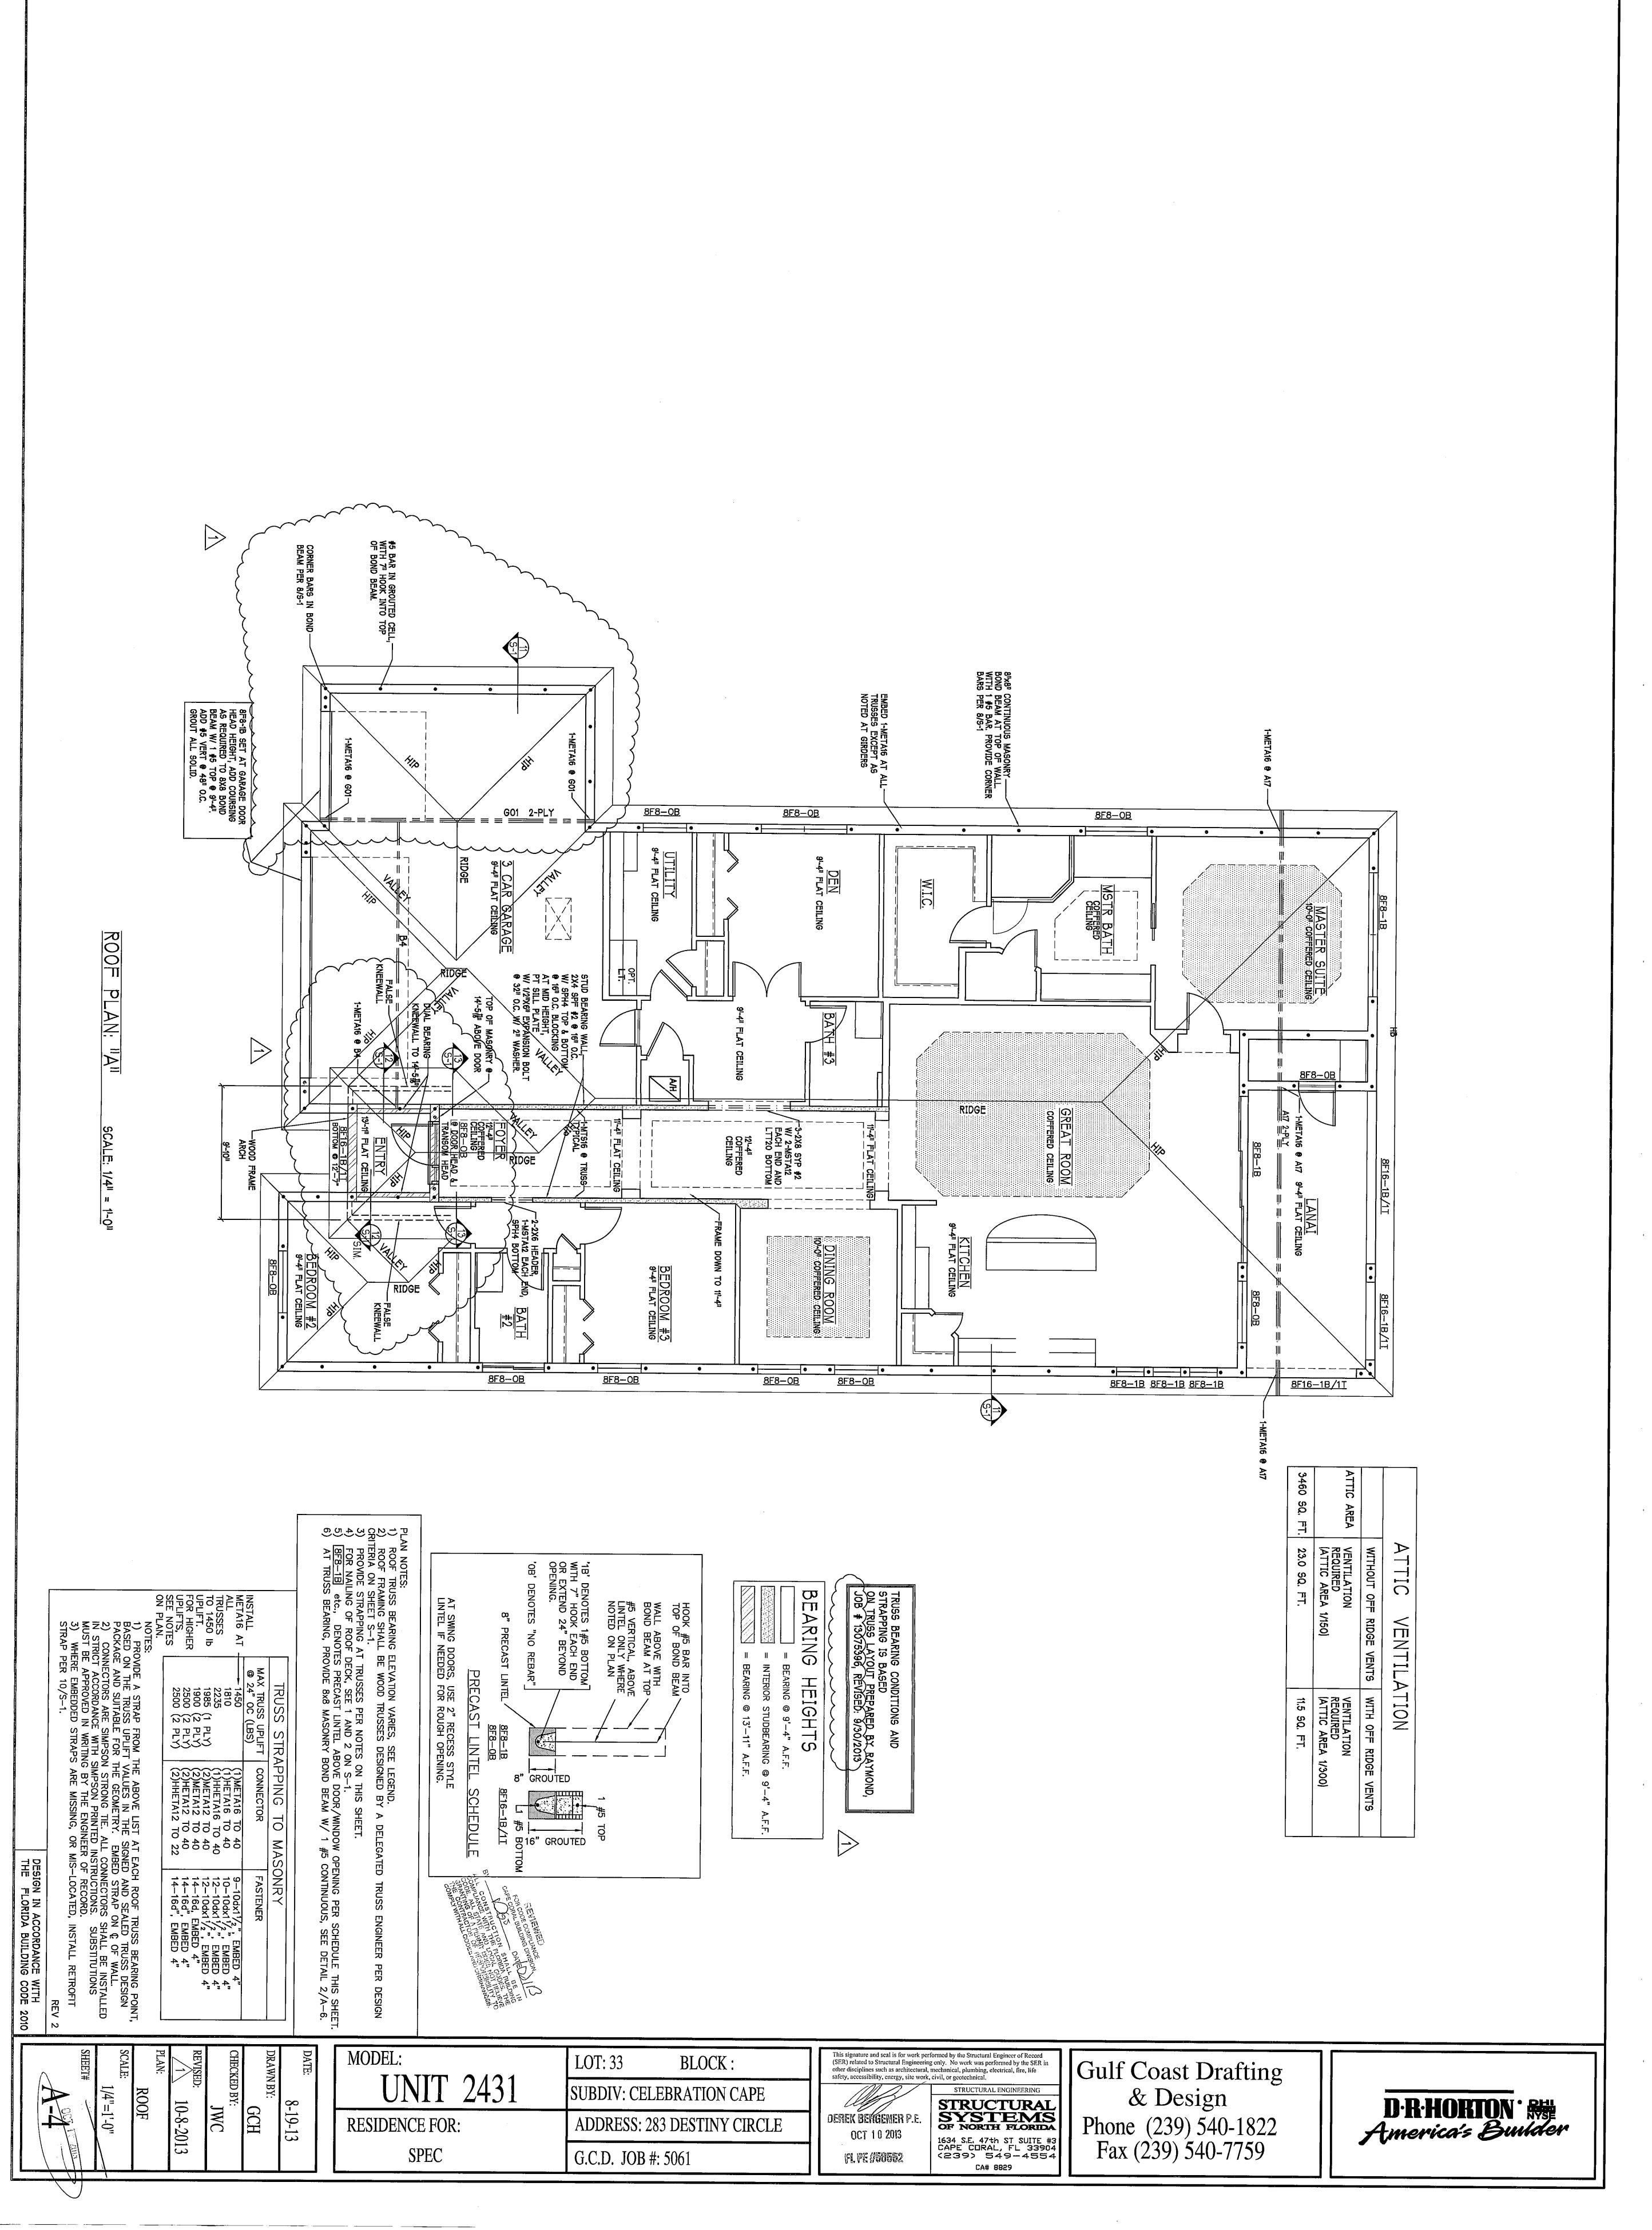

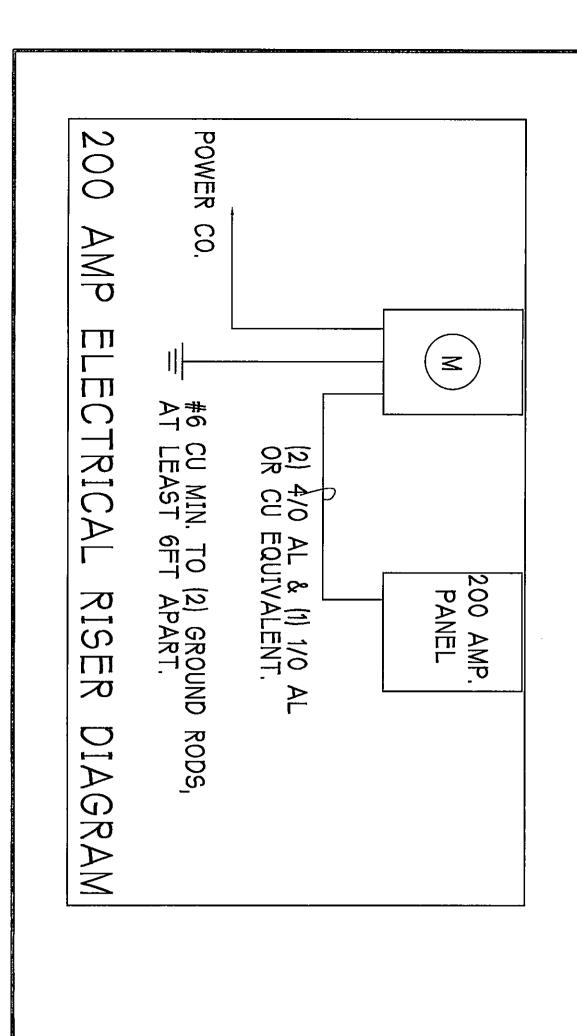

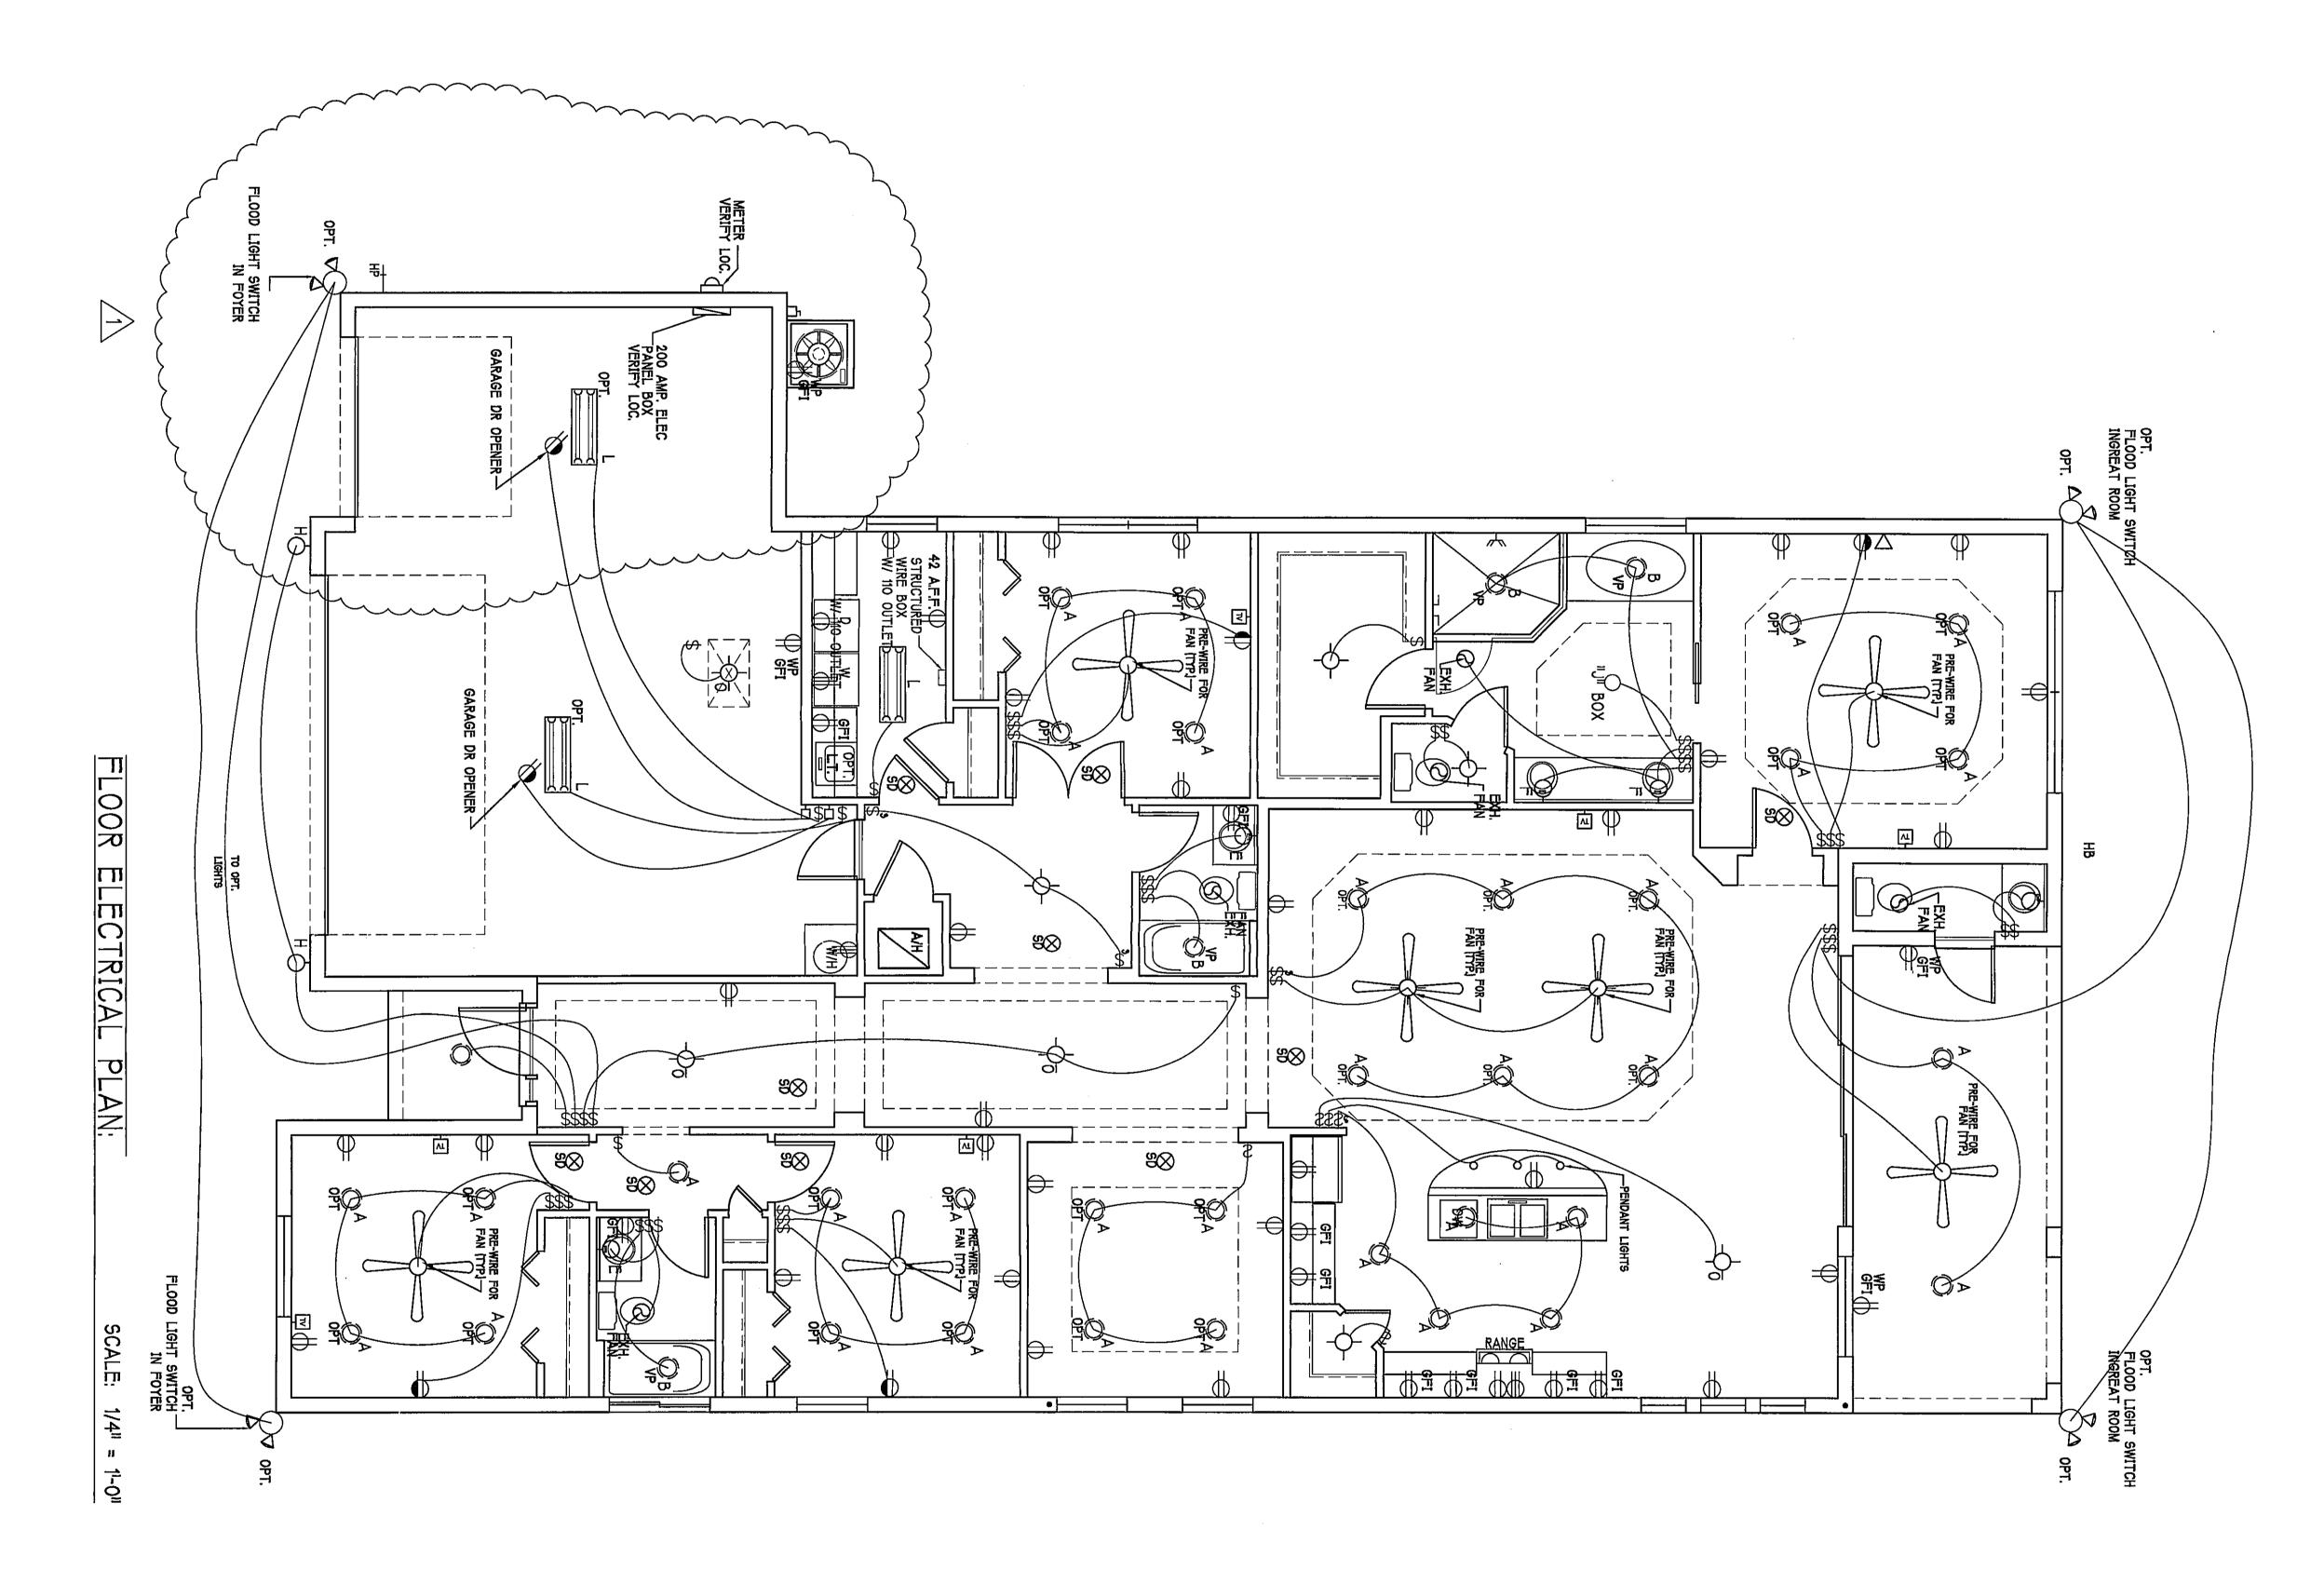

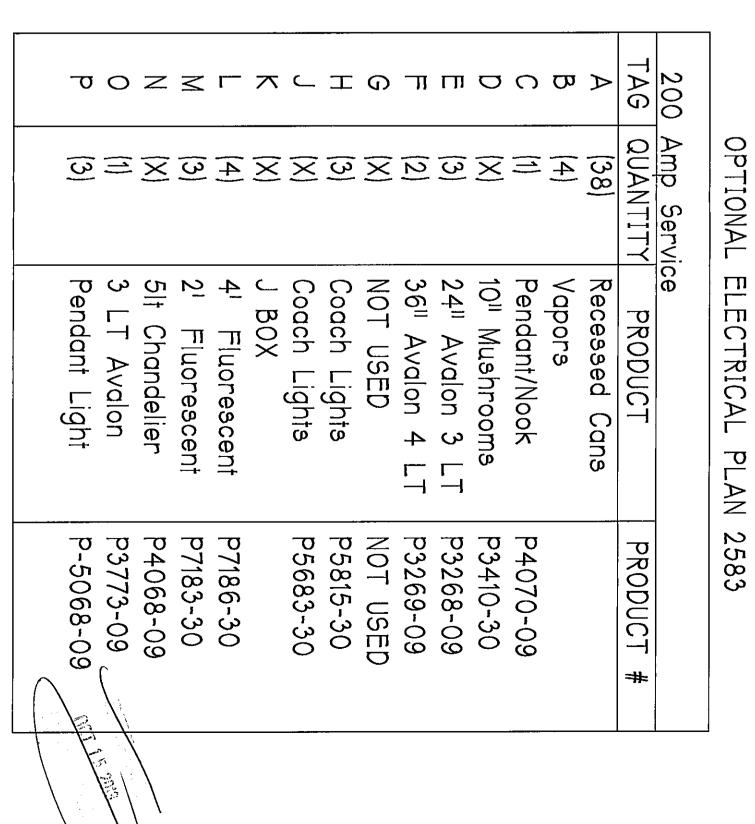

									<u> </u>		· ·	[2]				<u>(X)</u>	\$	( <del>\$3</del>	\$
Ĭ	1		8	古	Ţ	$\Delta \Delta$	0	20	$\cup$	Q	<del>-</del> ф-	ك				)SD	+	<del>)</del> 3	ωp
T I LLUONLOCKINI	A) FILIORESCENT LIGHT	KEYPAD	DOOR BELL	PUSH BUTTON	A/C DISCONNECT	TRACK MTD. LIGHTS	EXHAUST FAN	DUPLEX FLOOD LIGHT	WALL MTD. BRACKET LIGHT	RECESSED LIGHT	SURFACE MOUNTED CEILING LIGHT	TELEVISION RECEPTION OUTLET	TELEPHONE OUTLET	OPERATIONAL CARBON MONOXIDE ALARM INSTALLED WITHIN 10 FEET OF EACH ROOM USED FOR SLEEPING PERPOSES.  PER RULE 9B-3.04.72	AN ATTACHED GARAGE SHALL HAVE AN	AC/DC SMOKE DETECTOR TO BE INTERCONNECTED ANY RESIDENT HAVING A FOSSIL-BURNING	SINGLE POLE SWITCH	3 WAY SWITCH	DIMMER SWITCH

ting
ung
822
<b>39</b>
822 59

D.R.HORTON Reservica's Builder

ELECTRICAL LEGE

ELECTRICAL METER

ELECTRICAL PANEL

O 120 V JUNCTION BOX


SINGLE RECEPTACLE OUTLET

LEGEND

			\				
A-5AB	SHEET#	$\frac{\text{SCALE}}{1/4"} = 1'-0"$	PLAN: ELECTRICAL	REVISED: 10-8-2013	CHECKED BY: JWC	DRAWN BY: GCH	8-19-13

DESIGN IN ACCORDANCE WITH THE FLORIDA BUILDING CODE 2010

MODEL:	LOT: 33 BLOCK:				
UNIT 2431	SUBDIV: CELEBRATION CAPE				
RESIDENCE FOR:	ADDRESS: 283 DESTINY CIRCLE				
SPEC	G.C.D. JOB #: 5061				

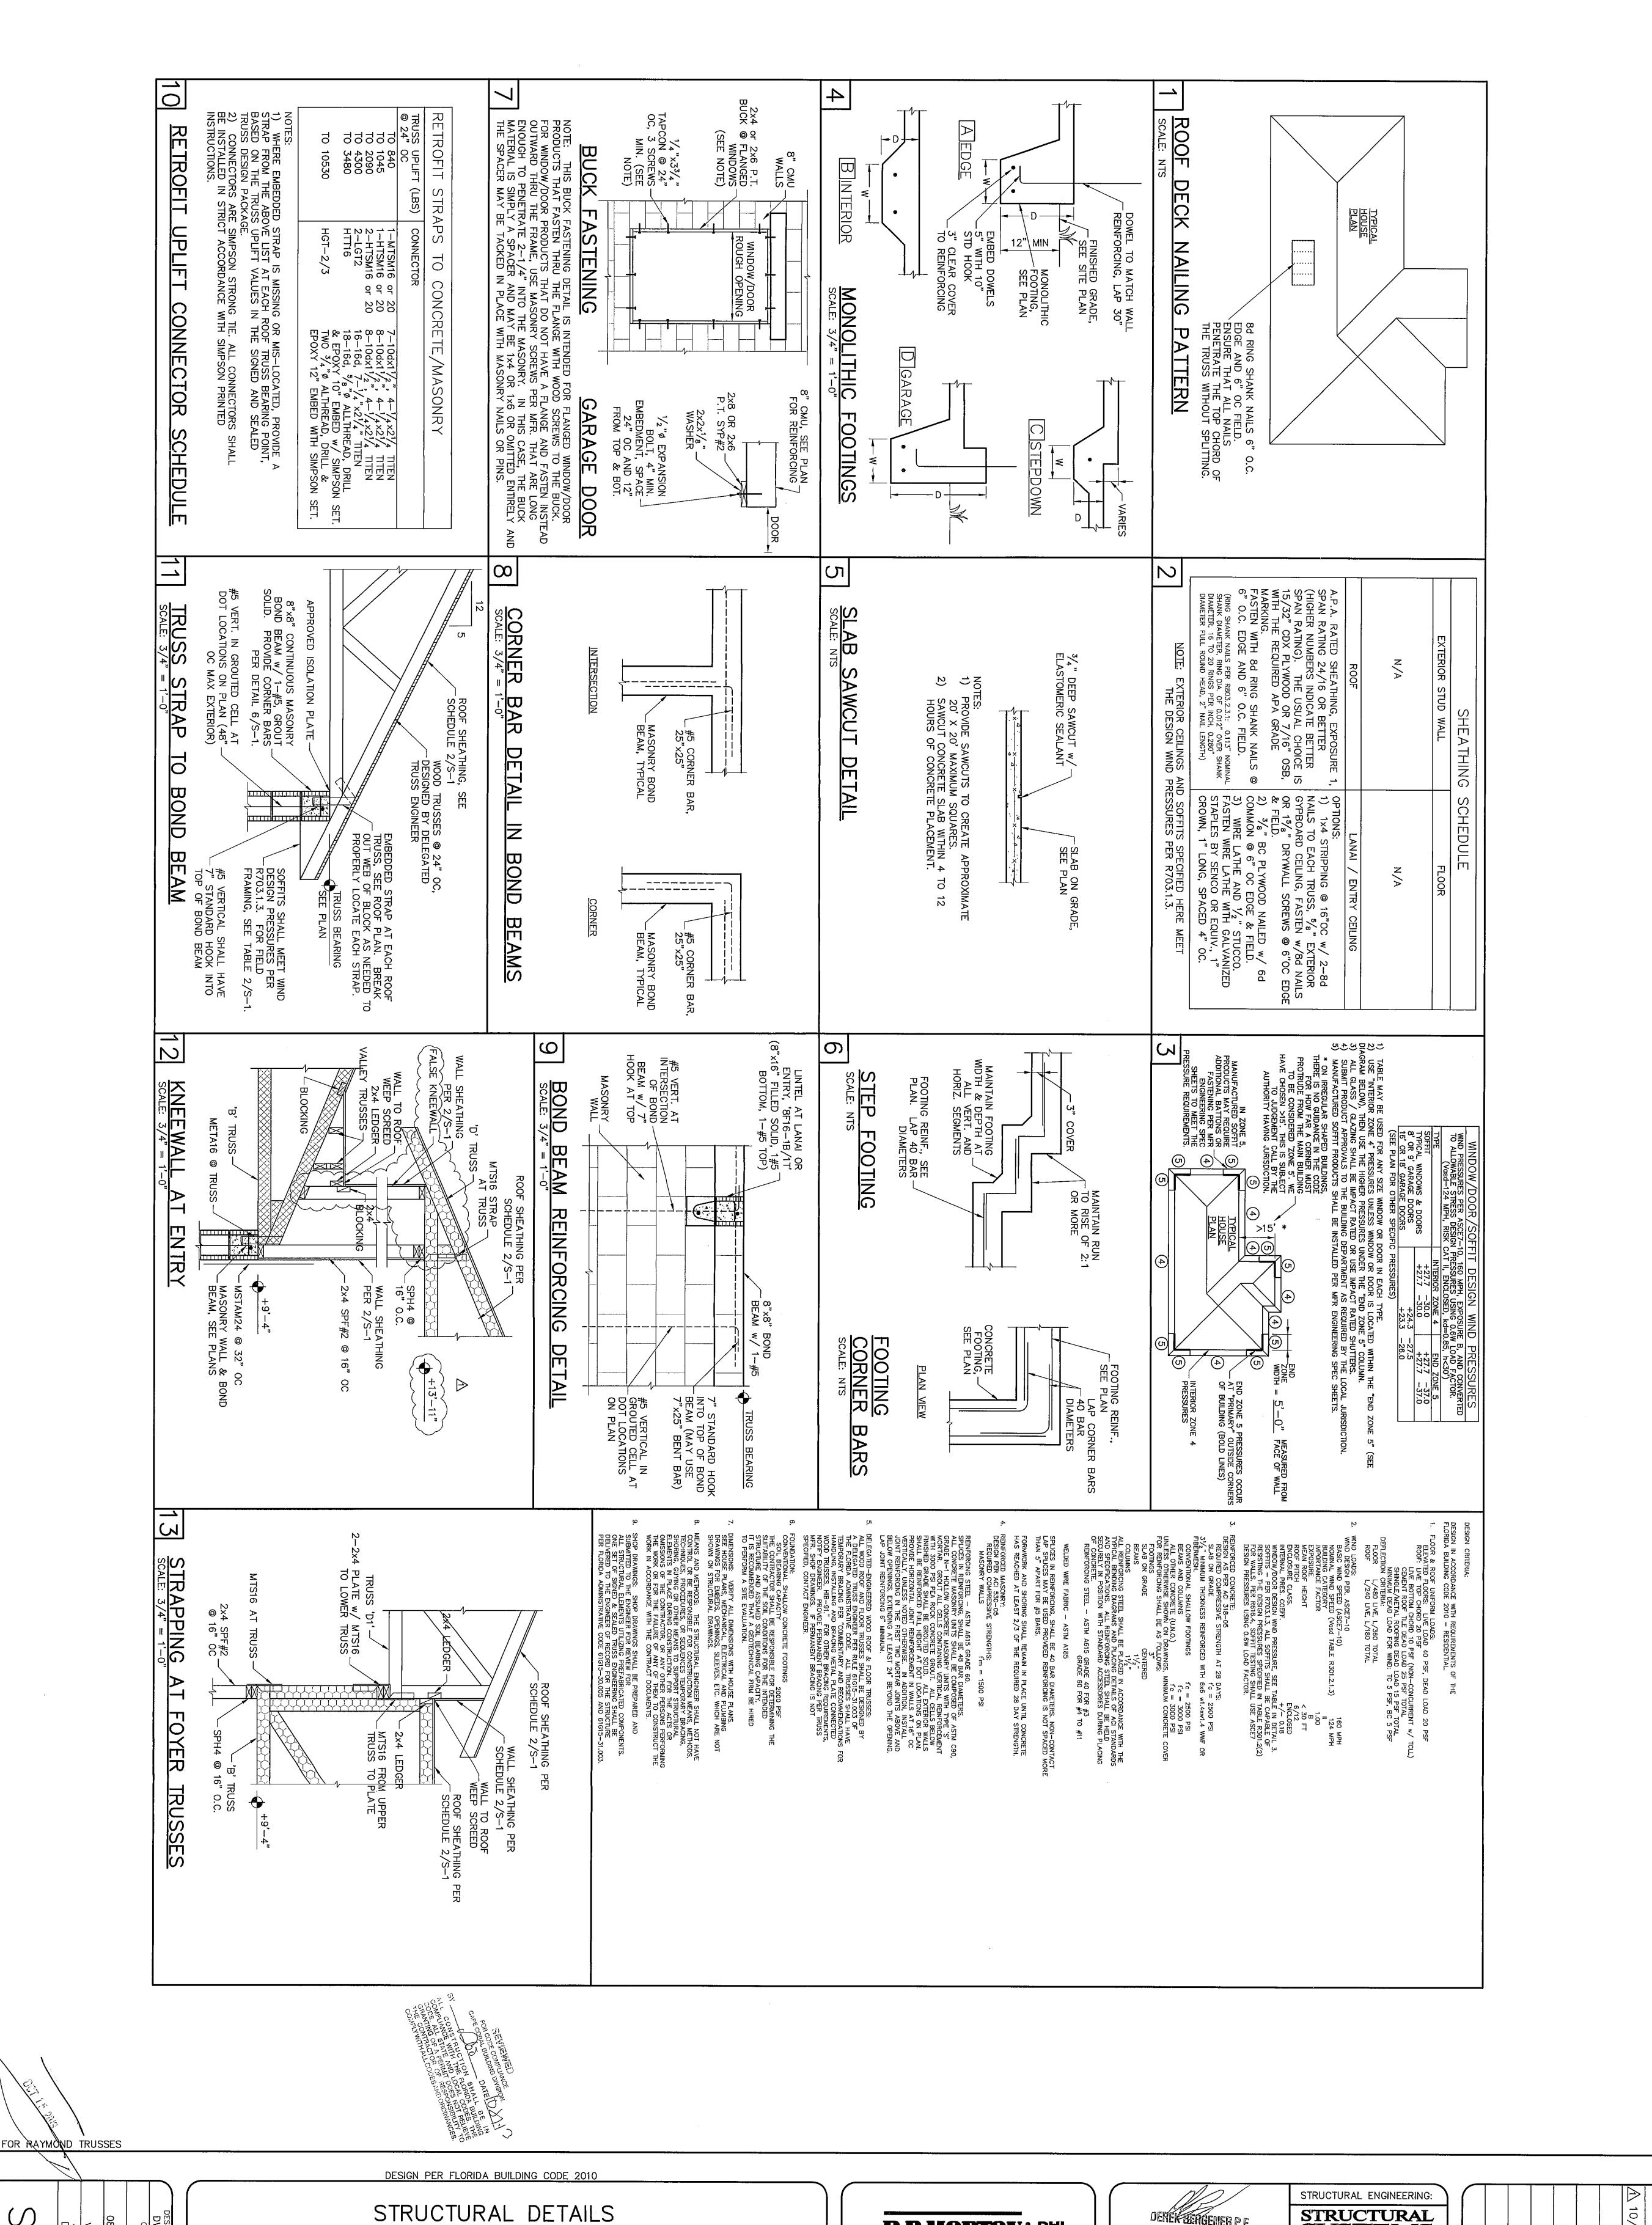

DESIGN/DRAWN
DWB/DWB
CHECKED
DWB
DATE
08/19/13
SCALE
VARIES
JOB NO.
DR5061
SHEET

STRUCTURAL DETAILS
MODEL 2431 A

283 DESTINY CIRCLE
CAPE CORAL, FLORIDA
LOT: 33 SUBDIVISION: CELEBRATION CAPE

D·R·HORTON : Right America's Builder



STRUCTURAL ENGINEERING:

STRUCTURAL
SYSTEMS
OF NORTH FLORIDA

1634 S.E. 47th STREET, SUITE #3
CAPE CORAL, FL 33904
(239) 549-4554
CA# 8829

